


AS BUILT NOTES:

1. THE AS-BUILT DRAWINGS SHOWN HERE ARE FOR REFERENCE PURPOSES ONLY. DRAWINGS ARE BASED ON MEASUREMENTS TAKEN IN THE FIELD 7-5-16. ALL DIMENSIONS RELATIVE TO OR BASED UPON AN EXISTING CONDITION ARE TO BE FIELD VERIFIED BY THE CONTRACTOR PRIOR TO CONSTRUCTION.
2. THE CONTRACTOR SHALL FIELD VERIFY ALL EXISTING CONDITIONS ON SITE. PLEASE NOTIFY ARCHITECT IN WRITING OF ANY DISCREPANCIES.
3. MECHANICAL CHASES, PANEL BOXES AND INTERIOR PLUMBING RISERS ARE NOT INDICATED ON THESE PLANS AND SHOULD BE FIELD VERIFIED.
4. BELOW GRADE CONDITIONS OF SLABS, CRAWL SPACE AND BASEMENT FOOTINGS HAVE NOT BEEN VERIFIED. CONTRACTOR SHALL INSPECT EXISTING CONDITIONS BY EXCAVATING TO ANY CRUCIAL AREAS PRIOR TO CONSTRUCTION TO DETERMINE WHETHER ADDITIONAL STRUCTURAL FOUNDATION WORK IS REQUIRED. CONTRACTOR SHALL CONTACT LICENSED STRUCTURAL ENGINEER IF ANY EXISTING CONDITION IS SUBSTANDARD. CONTRACTOR SHALL NOT COMPROMISE STRUCTURAL INTEGRITY OF EXISTING STRUCTURE DURING DEMOLITION. CONTRACTOR SHALL PROVIDE SHORING AND OR BRACING OF EXISTING STRUCTURE DURING EXCAVATION AND DEMOLITION.
5. IN THE EVENT OF SUB-STANDARD EXISTING CONSTRUCTION OR STRUCTURE, THE OWNER SHALL UNDERSTAND THAT THIS WORK WOULD CONSTITUTE AN UNFORESEEN EXISTING CONDITION.

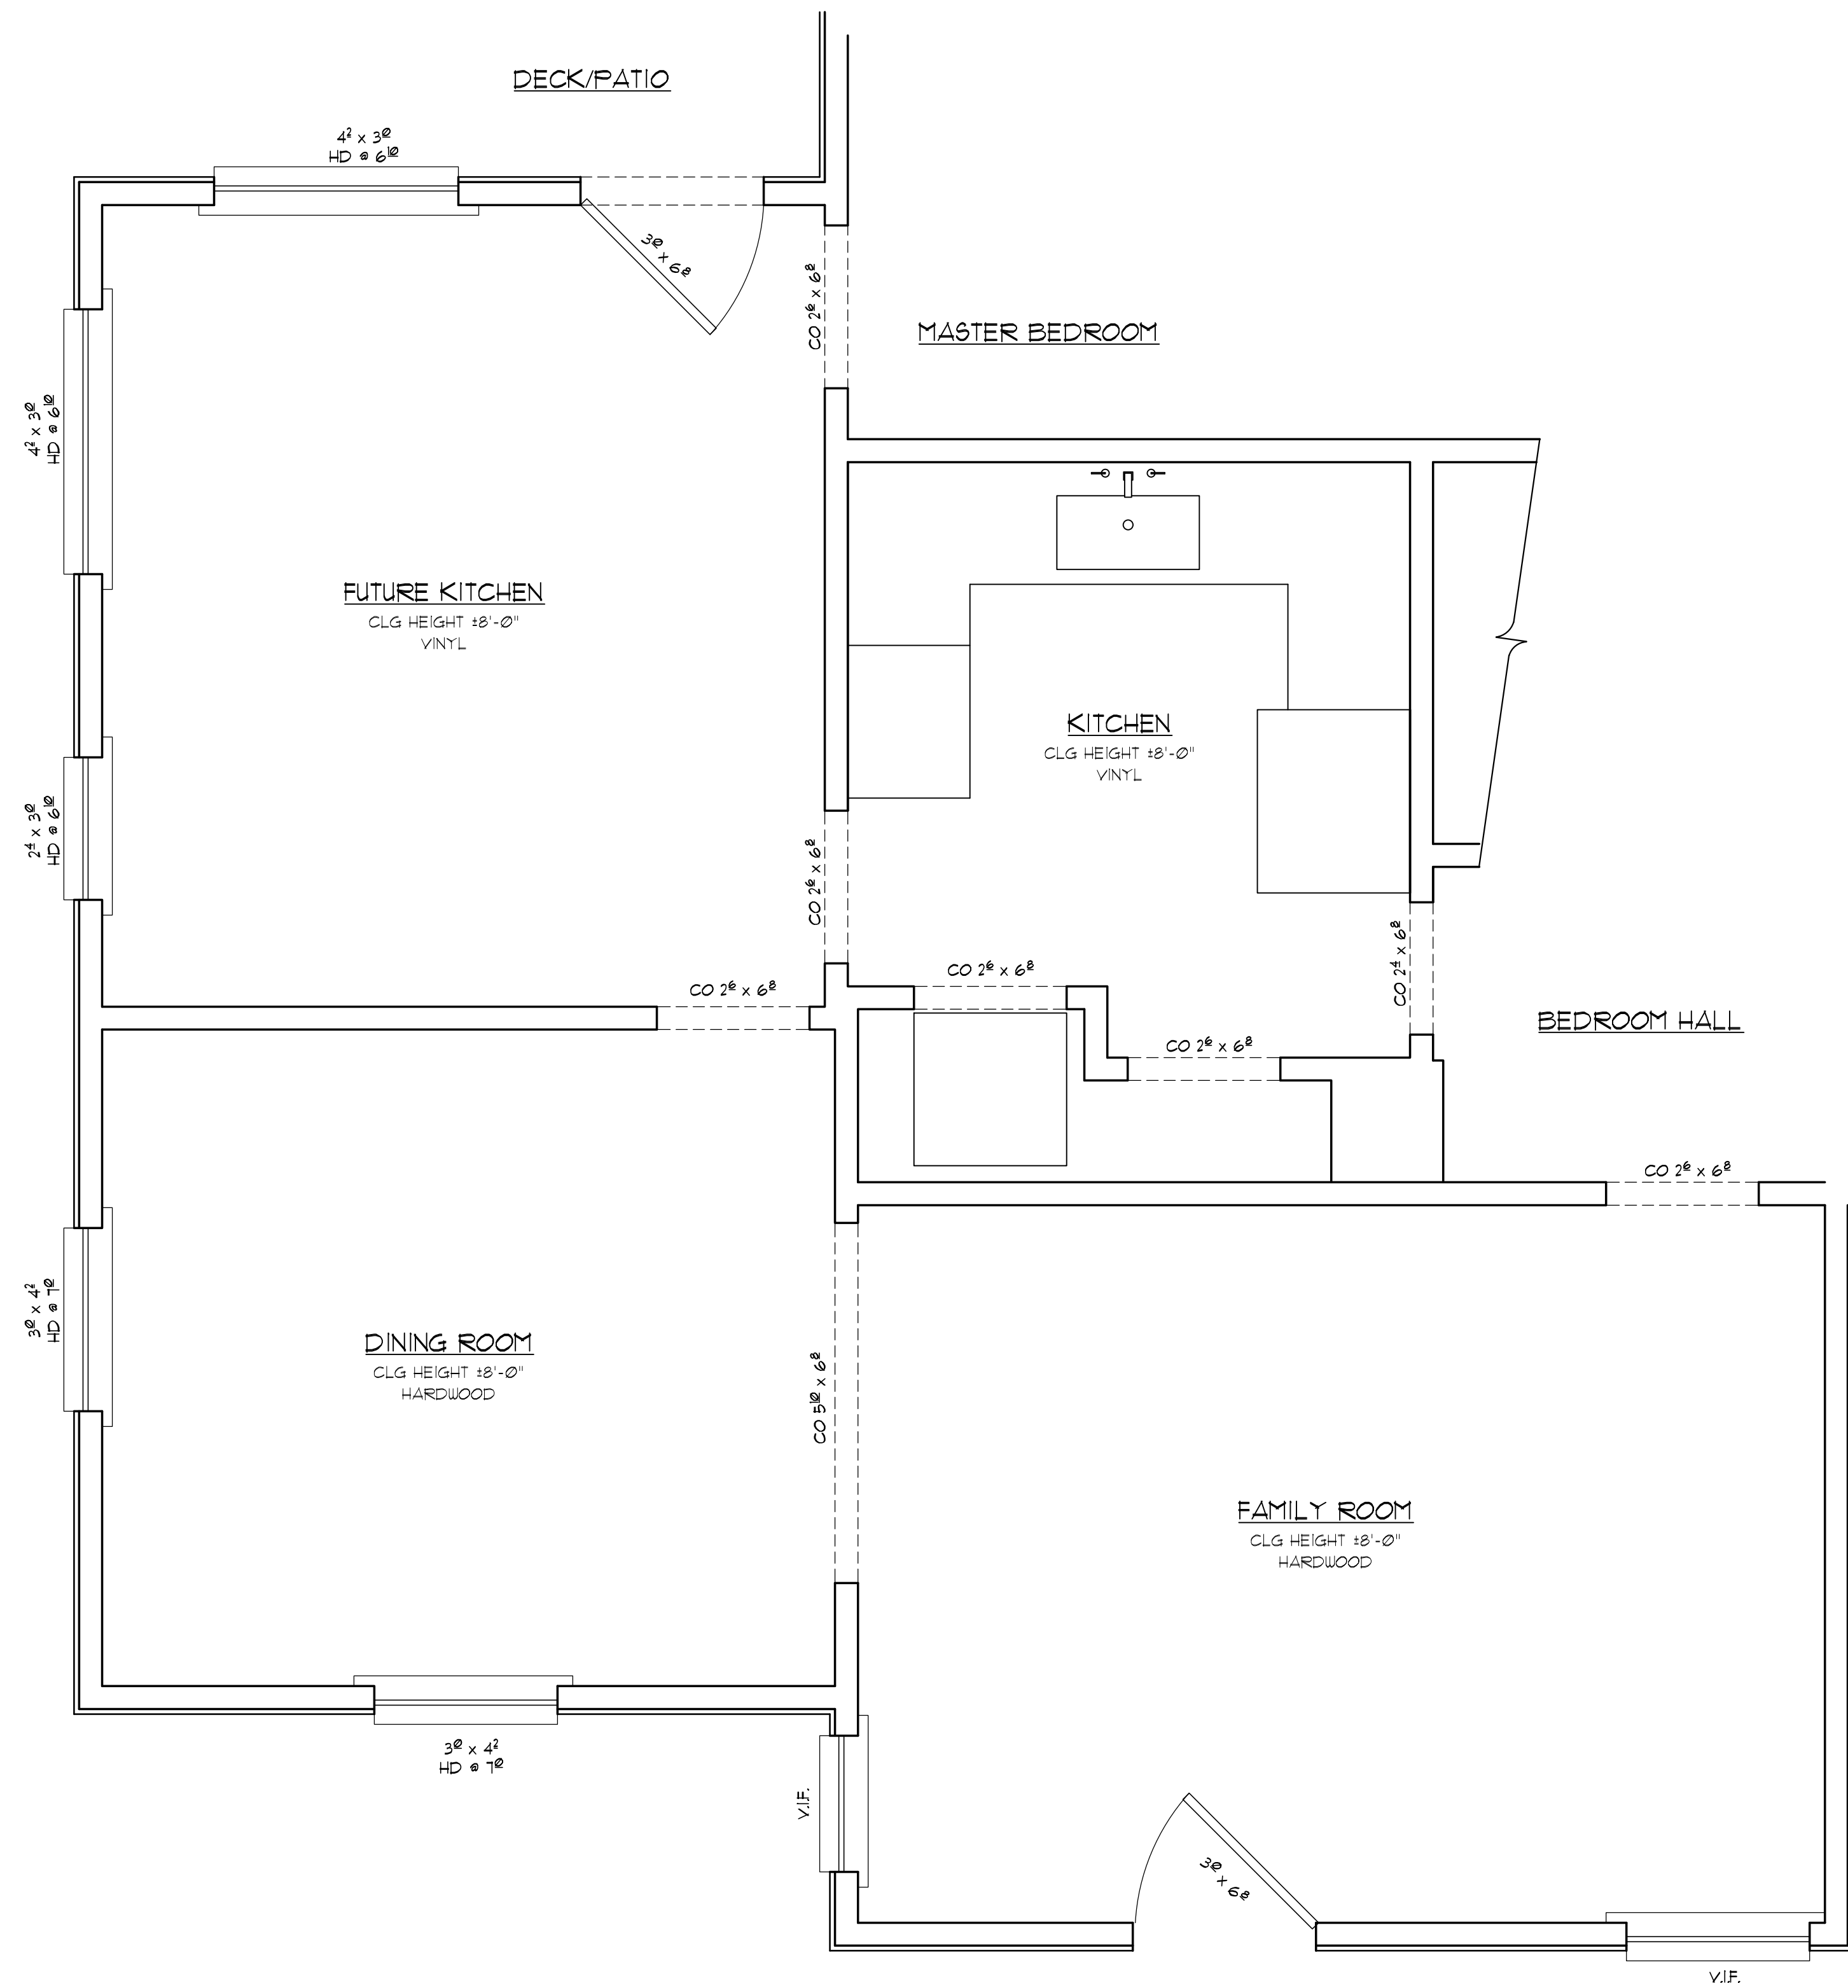

1 PARTIAL AS BUILT PLAN
 AB-1 SAMPLE RENOVATION 1/2" = 1'-0"

REVISIONS	BY

SAMPLE RENOVATION PLAN

EK INTERIORS





RENOVATION PLAN



USE OF THIS DOCUMENT:
 This drawing and associated documents are the exclusive property of EK Interiors, and are not to be reproduced or copied in whole or in part. They are only to be used for the project and site specifically identified herein and are not to be used on any other project without the written permission of the designers.

SCALE OF THE DRAWING:
 Scales as stated on this drawing are valid on the original drawing only, the dimension of which is 24 x 36 inches.

Date
Scale
Drawn
Job
Sheet
AB-1
Of Sheets

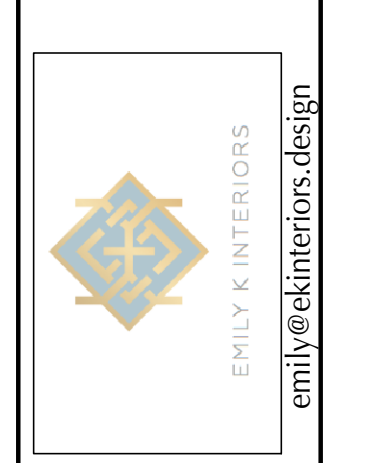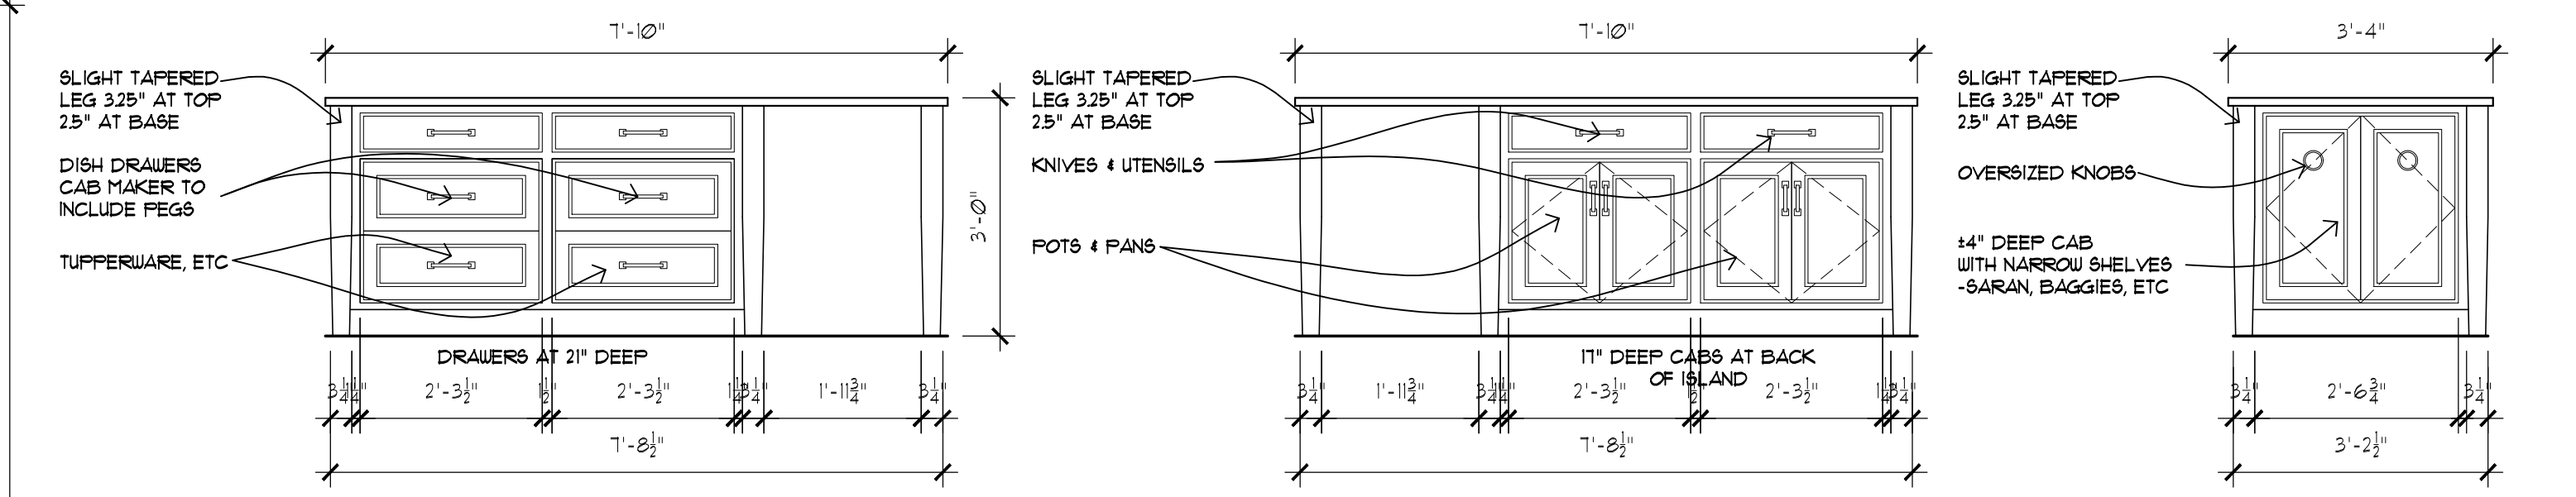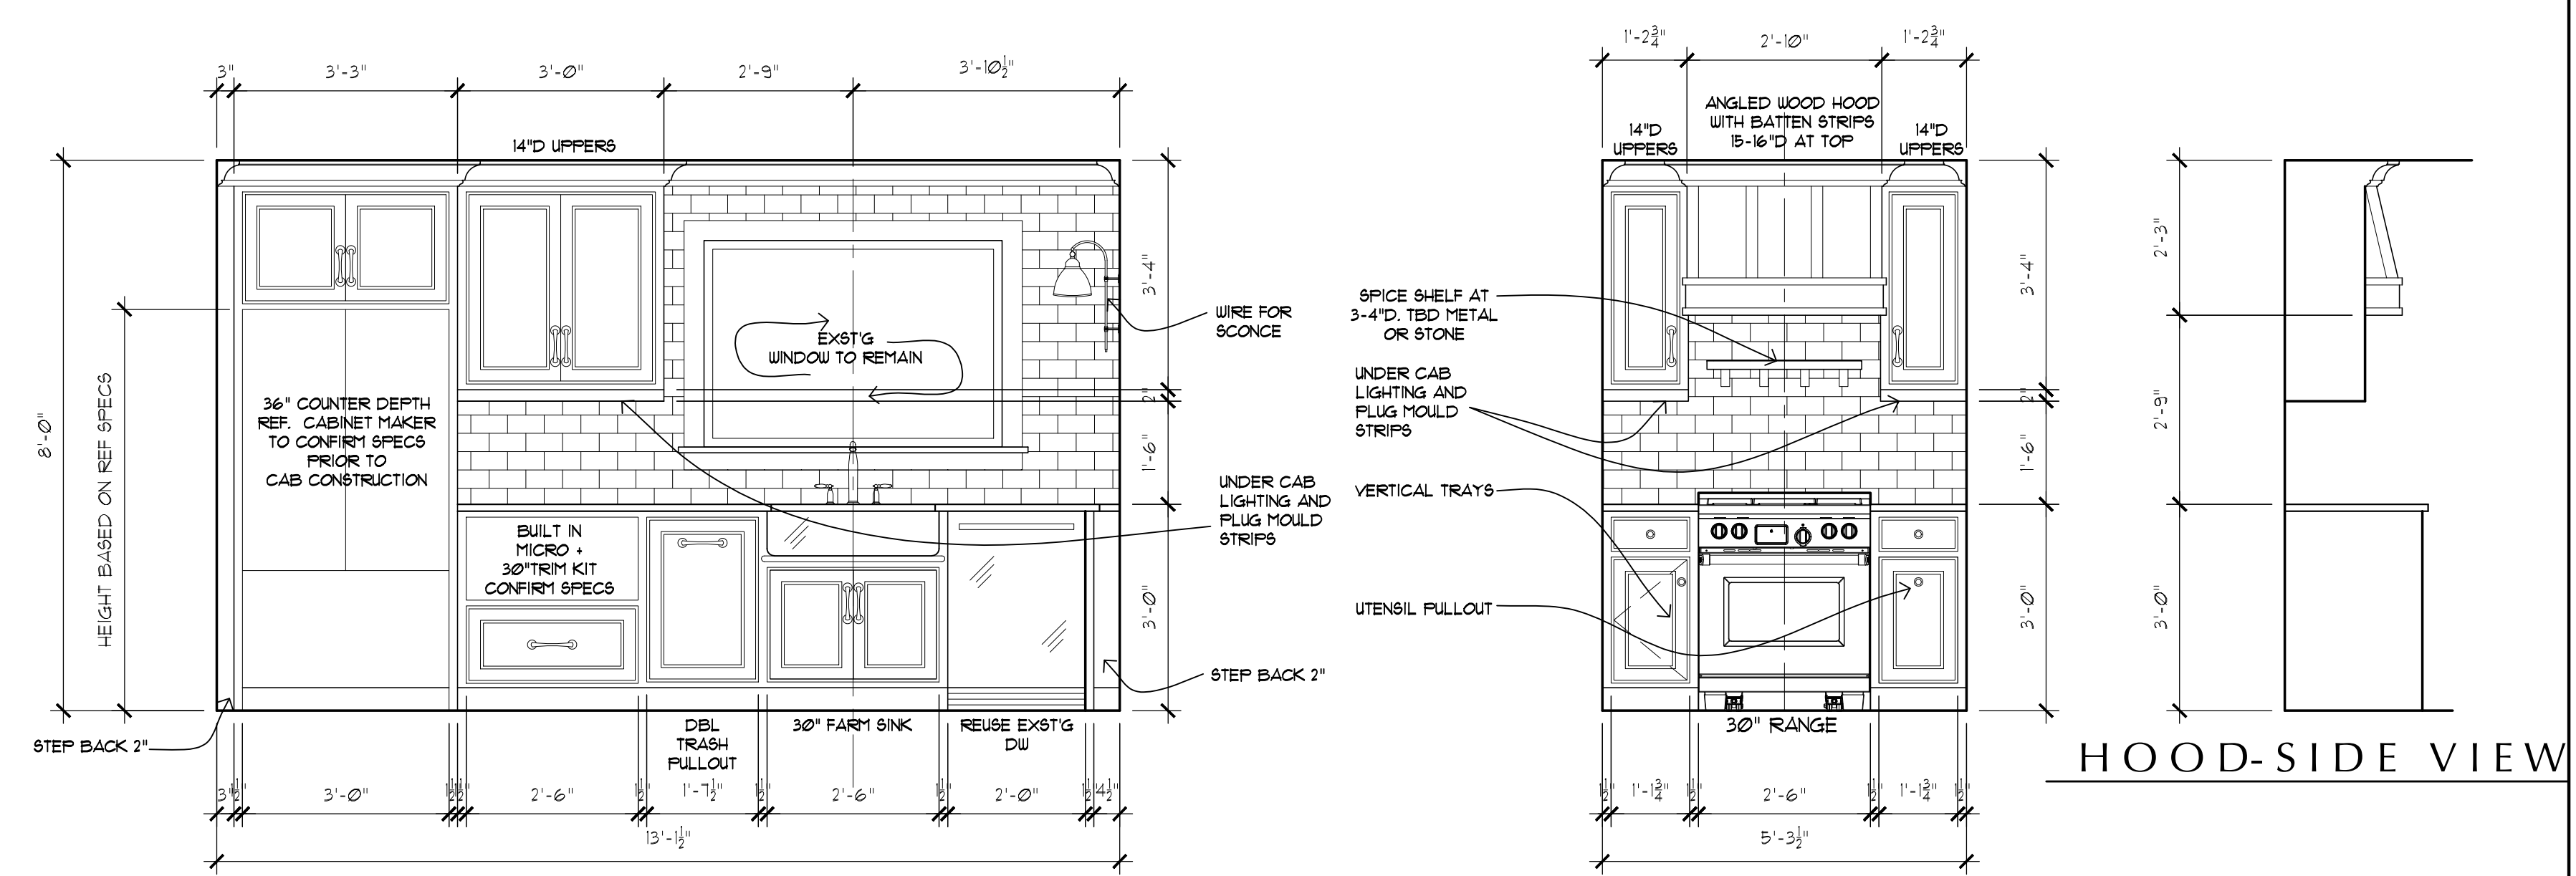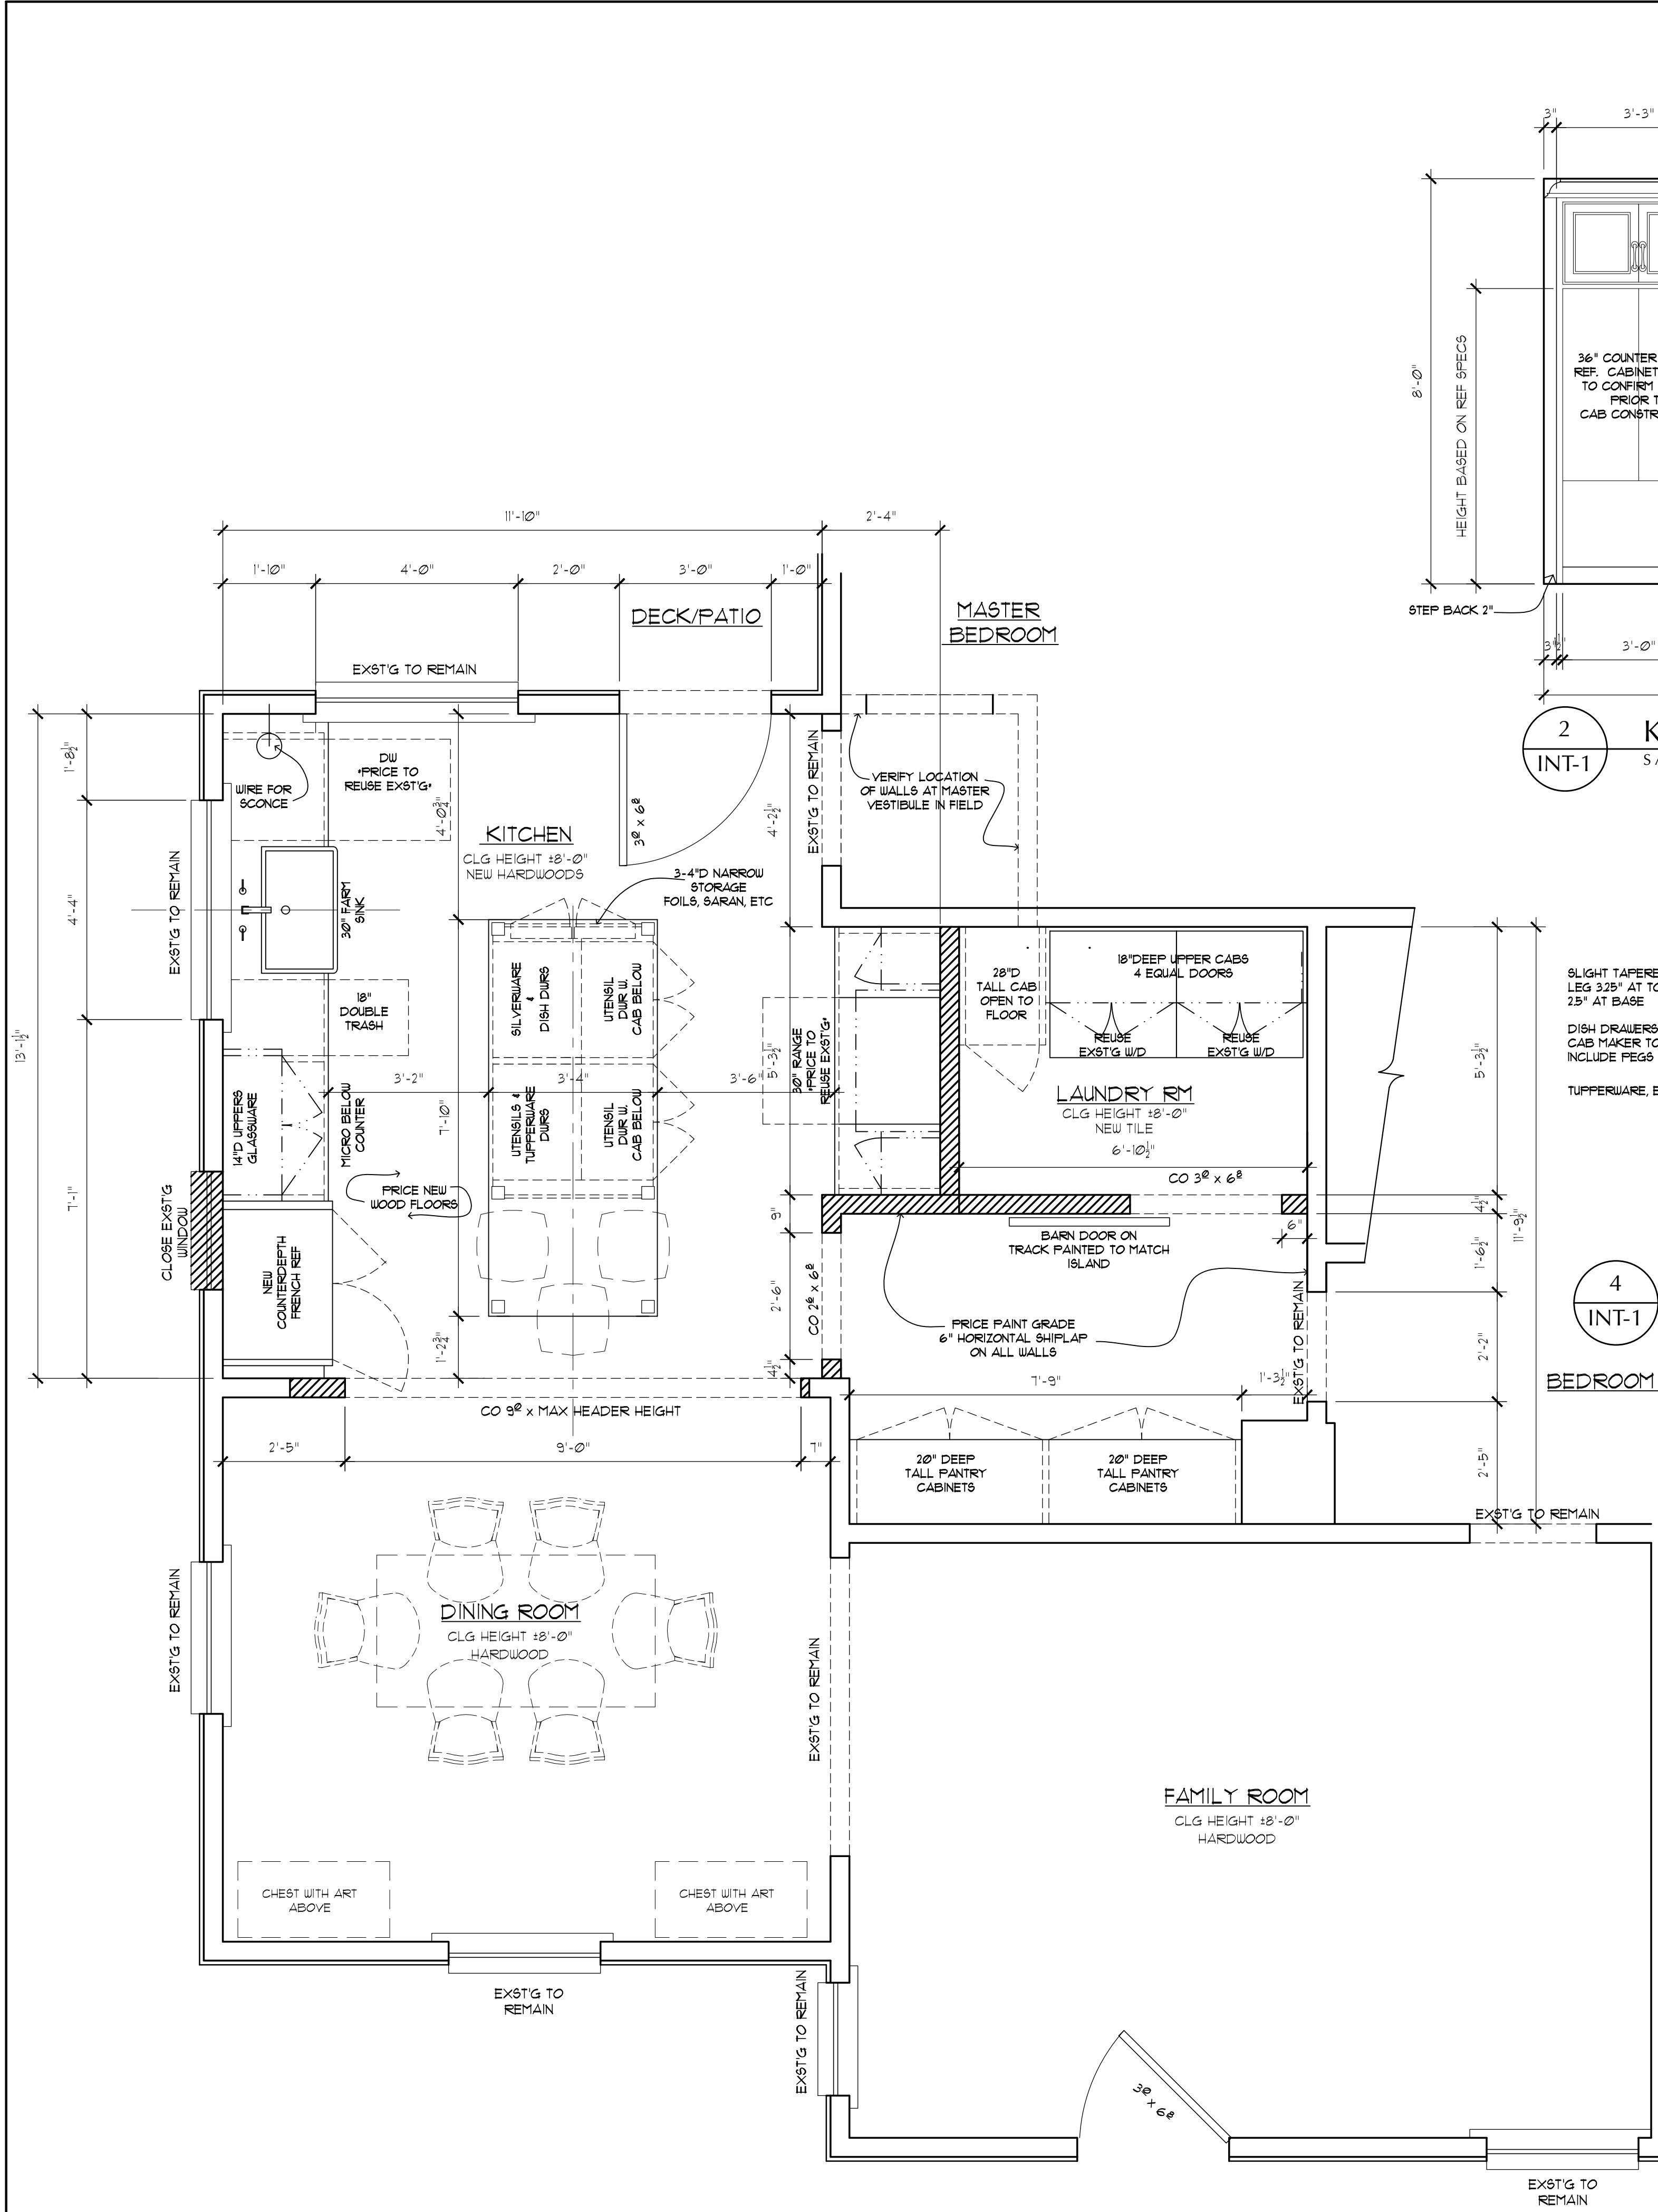

USE OF THIS DOCUMENT:
 This drawing and associated documents are the exclusive property of EK Interiors, and are not to be reproduced or copied in whole or in part. They are only to be used for the project and site specifically identified herein and are not to be used on any other project without the written permission of the designers.


SCALE OF THE DRAWING:
 Scales as stated on this drawing are valid on the original drawing only, the dimension of which is 24 x 36 inches.

Date
Scale
Drawn
Job
Sheet
INT-1
Of Sheets

REVISIONS	BY

SAMPLE RENOVATION PLAN

EK INTERIORS

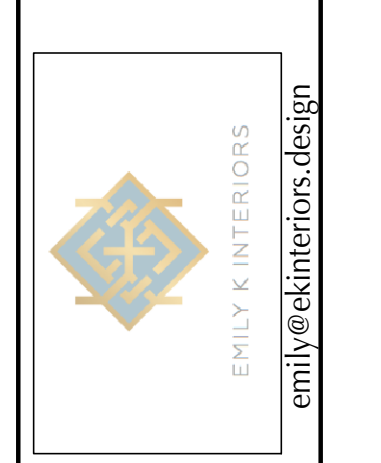

USE OF THIS DOCUMENT:
This drawing and associated documents are the exclusive property of EK Interiors, and are not to be reproduced or copied in whole or in part. They are only to be used for the project and site specifically identified herein and are not to be used on any other project without the written permission of the designers.

SCALE OF THE DRAWING:
Scales as stated on this drawing are valid on the original drawing only, the dimension of which is 24 x 36 inches.

Date
Scale
Drawn
Job
Sheet
INT-2
Of Sheets

